

PROPERTY STATUS		INTEREST TO BE ACQUIRED		GRANTOR		GRANTEE		LARGER AREA		GROSS TAKE		NET TAKE		REMAIN		RECORDED		ACQUIRED	
PARCEL NO.																			
1		FEE		OUZINKIE NATIVE CORP. (SURFACE)		STATE OF ALASKA, DOT/PF		LARGER		133,127 AC±		133,127 AC±		LARGER		2008-002195-0		3-02-02100-004-2008	
2		ILL.M.A.		DNR		STATE OF ALASKA, DOT/PF		LARGER		5,484 AC±		5,484 AC±		LARGER		2008-002198-0		3-02-02100-004-2008	
8		AVIGATION & HAZARD EASEMENT		OUZINKIE NATIVE CORP. (SURFACE)		STATE OF ALASKA, DOT/PF		LARGER		17,906 AC±		17,906 AC±		LARGER		2008-002196-0		3-02-02100-004-2008	
8				KONIAK INC. (SUBSURFACE)												2008-002197-0		3-02-02100-004-2008	

NOTE:
SEE RECORD OF SURVEY, AKSAS 5400, OUZINKIE AIRPORT RELOCATION,
AND ACCESS ROAD, DATED 10/10/06 FOR INFORMATION ON SURVEY
CONTROL AND COORDINATE SYSTEM.

(PF) DIMENSIONS TAKEN FROM
SOA DOT/PF OUZINKIE AIRPORT
PROPERTY PLAN, DATED 7/1/03
(USS 487)
RECORD DIMENSIONS PER PLAT OF
USS 487, DATED 1971
(REC) RECORD DIMENSIONS PER BLM PLAT
USS 5691
RECORD DIMENSIONS PER
ANSCA 14(C) PLAT

LEGEND

STATE OF ALASKA
DEPARTMENT OF TRANSPORTATION
AND PUBLIC FACILITIES
CENTRAL REGION - AVIATION

Date Drawn: 10/22/07
Designer:
Drawn by: GE
Checked by: PLH


OUZINKIE AIRPORT
EXHIBIT 'A'
AIRPORT PROPERTY PLAN
PROJECT No. 51864

KODIAK RECORDING DISTRICT



OUZINKIE AIRPORT

EXHIBIT 'A'

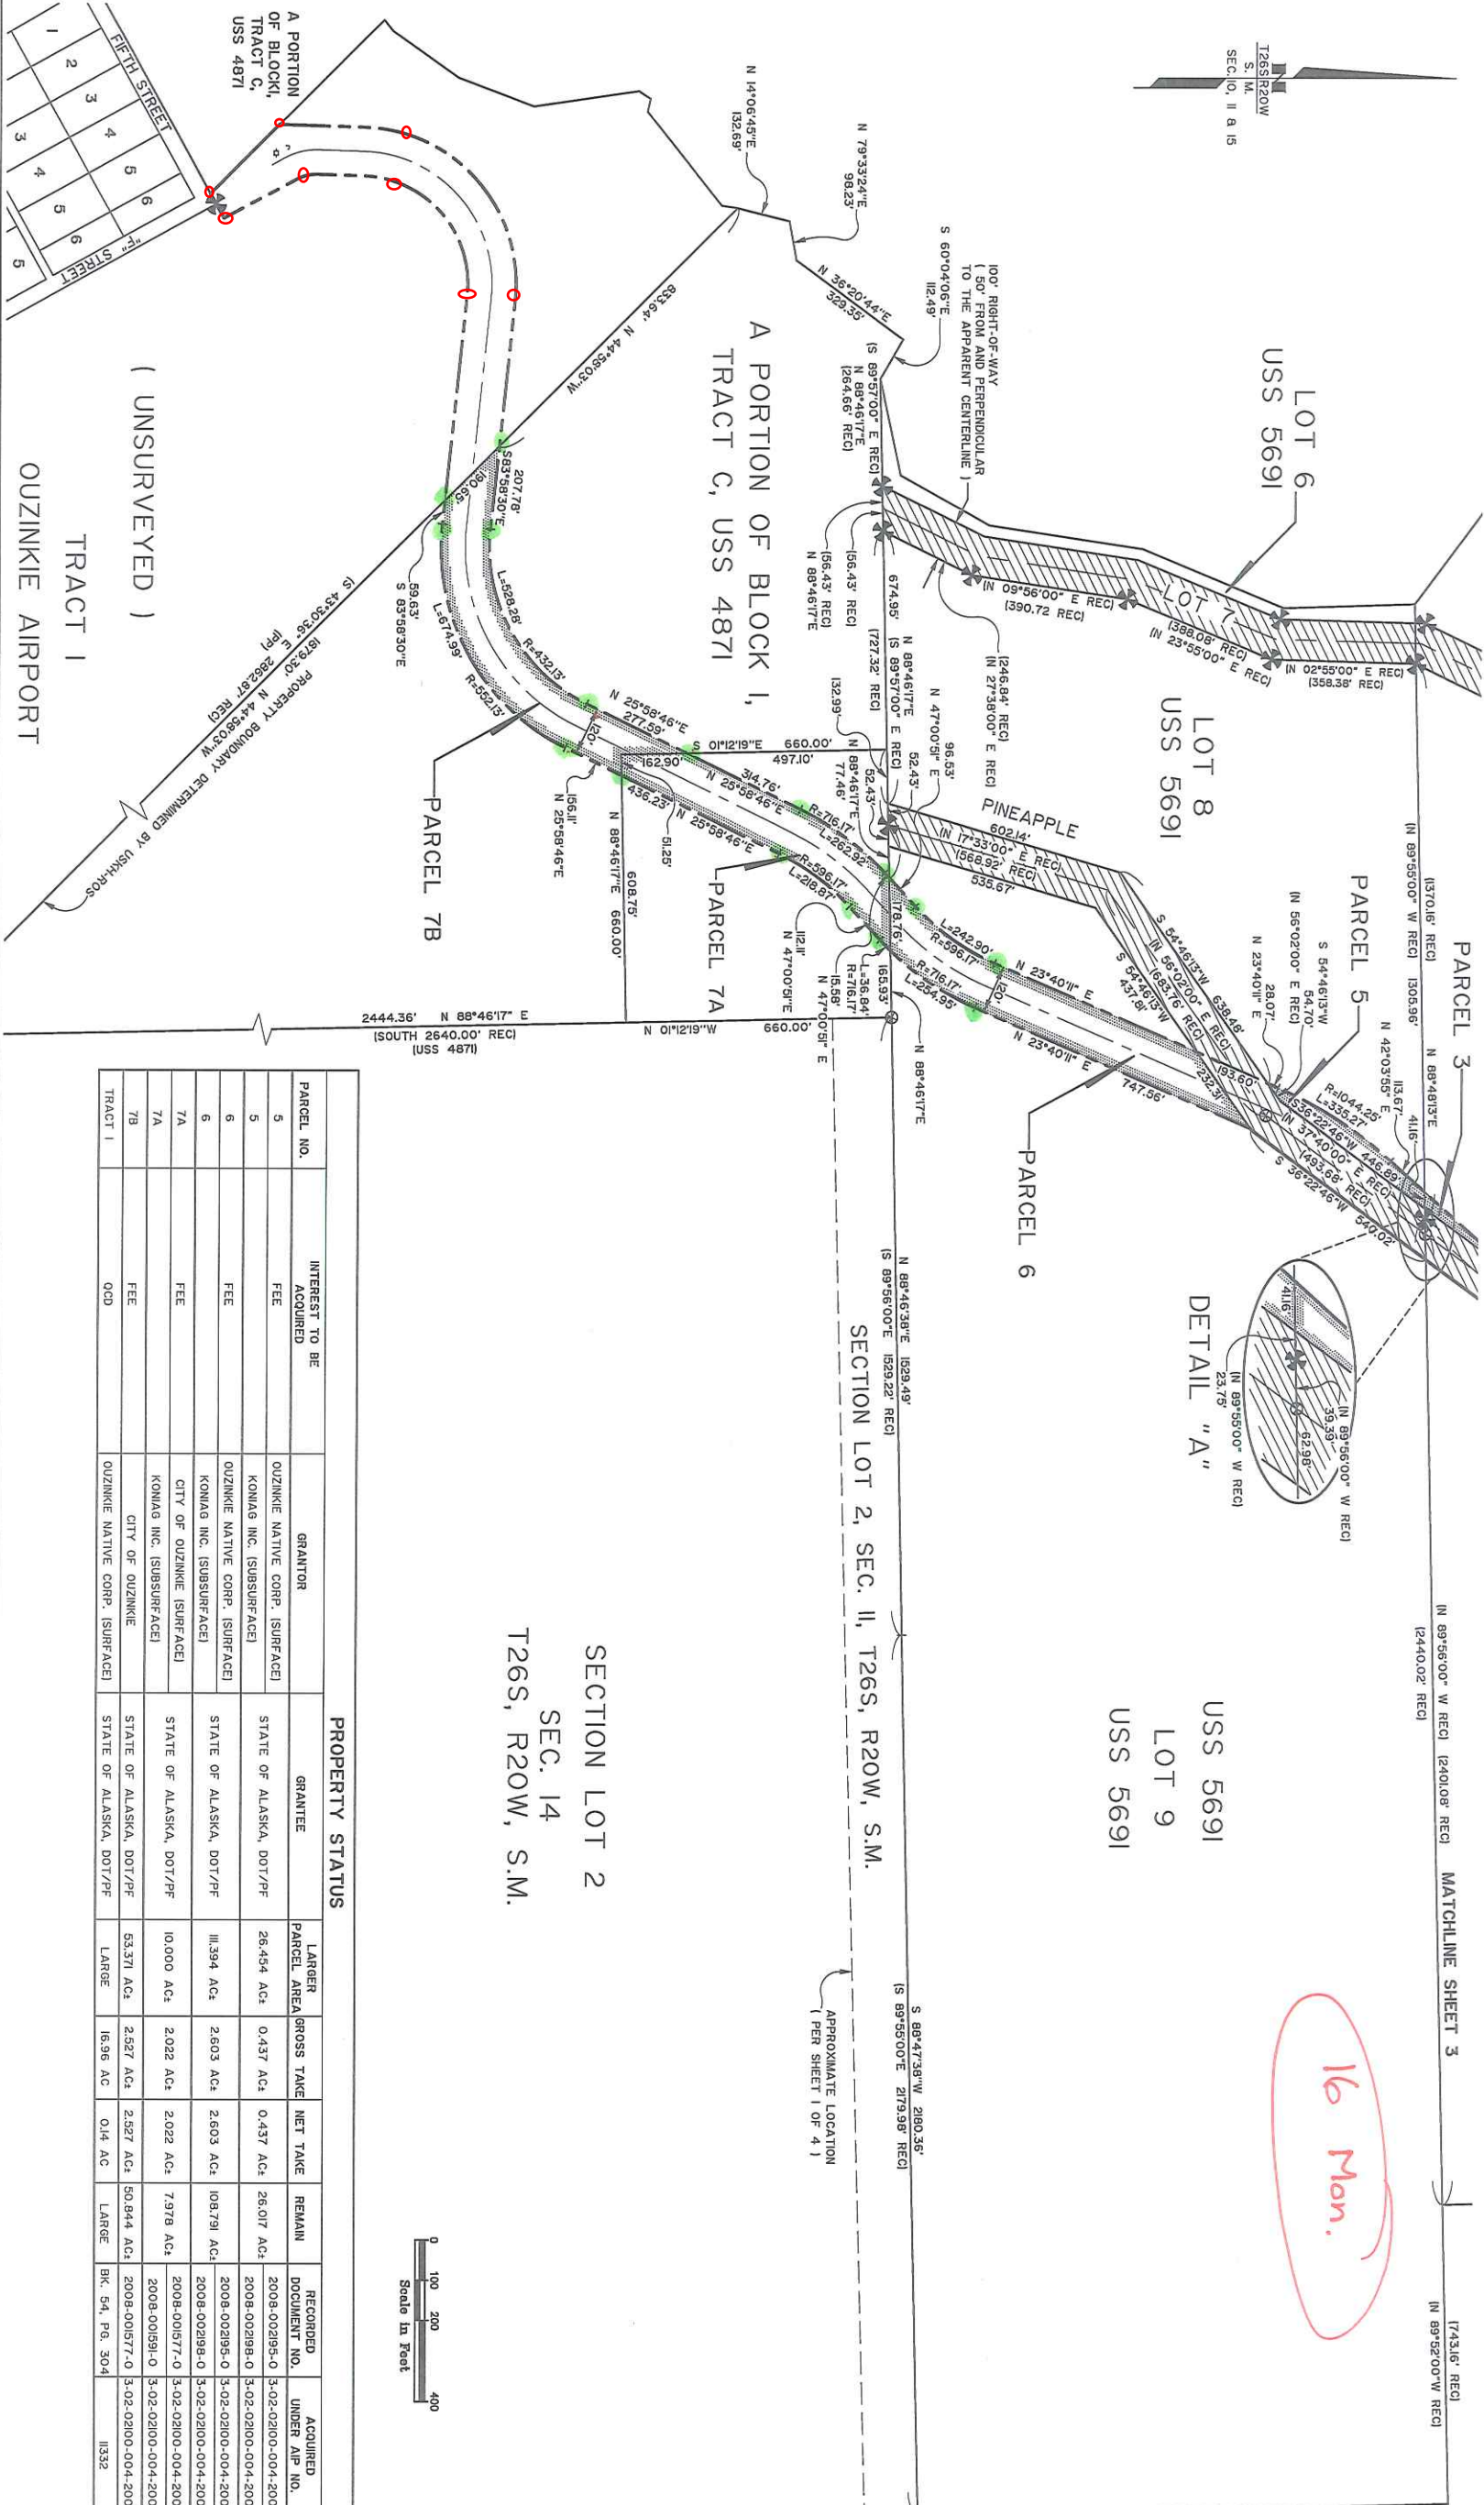

BY	DATE	REVISIONS

PROPERTY STATUS											
PARCEL NO.	INTEREST TO BE ACQUIRED	GRANTOR	GRANTEE	LARGER PARCEL AREA	GROSS TAKE	NET TAKE	REMAIN	RECORDED DOCUMENT NO.	ACQUIRED UNDER AIP NO.		
TRACT I	QCD	OUZINKIE NATIVE CORP. [SURFACE]	STATE OF ALASKA, DOT/PF	LARGE	16.96 AC	0.14 AC	LARGE	BR. 54, PG. 304	11332		

STATE OF ALASKA
DEPARTMENT OF TRANSPORTATION
AND PUBLIC FACILITIES
CENTRAL REGION - AVIATION

Date Drawn: 10/22/07
Designer:
Drawn by: GE
Checked by: PLH

OUZINKIE AIRPORT
EXHIBIT 'A'
AIRPORT PROPERTY PLAN
PROJECT NO. 51864

SHEET 4 OF 4