

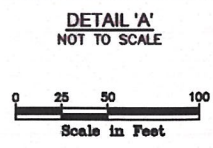
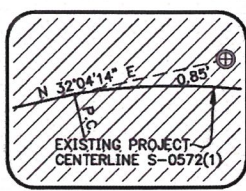


C:\Projects\AKDOT\APR\5184 Palmer Wasilla Hwy Phase II\Drawings\Civil 3D 2012\59271 Palmer Wasilla Hwy ROW Base Map 7/24/2014 12:42:52 PM


PROJECT DESIGNATION	SHEET NO.	TOTAL SHEETS
59271	R-11	R-41

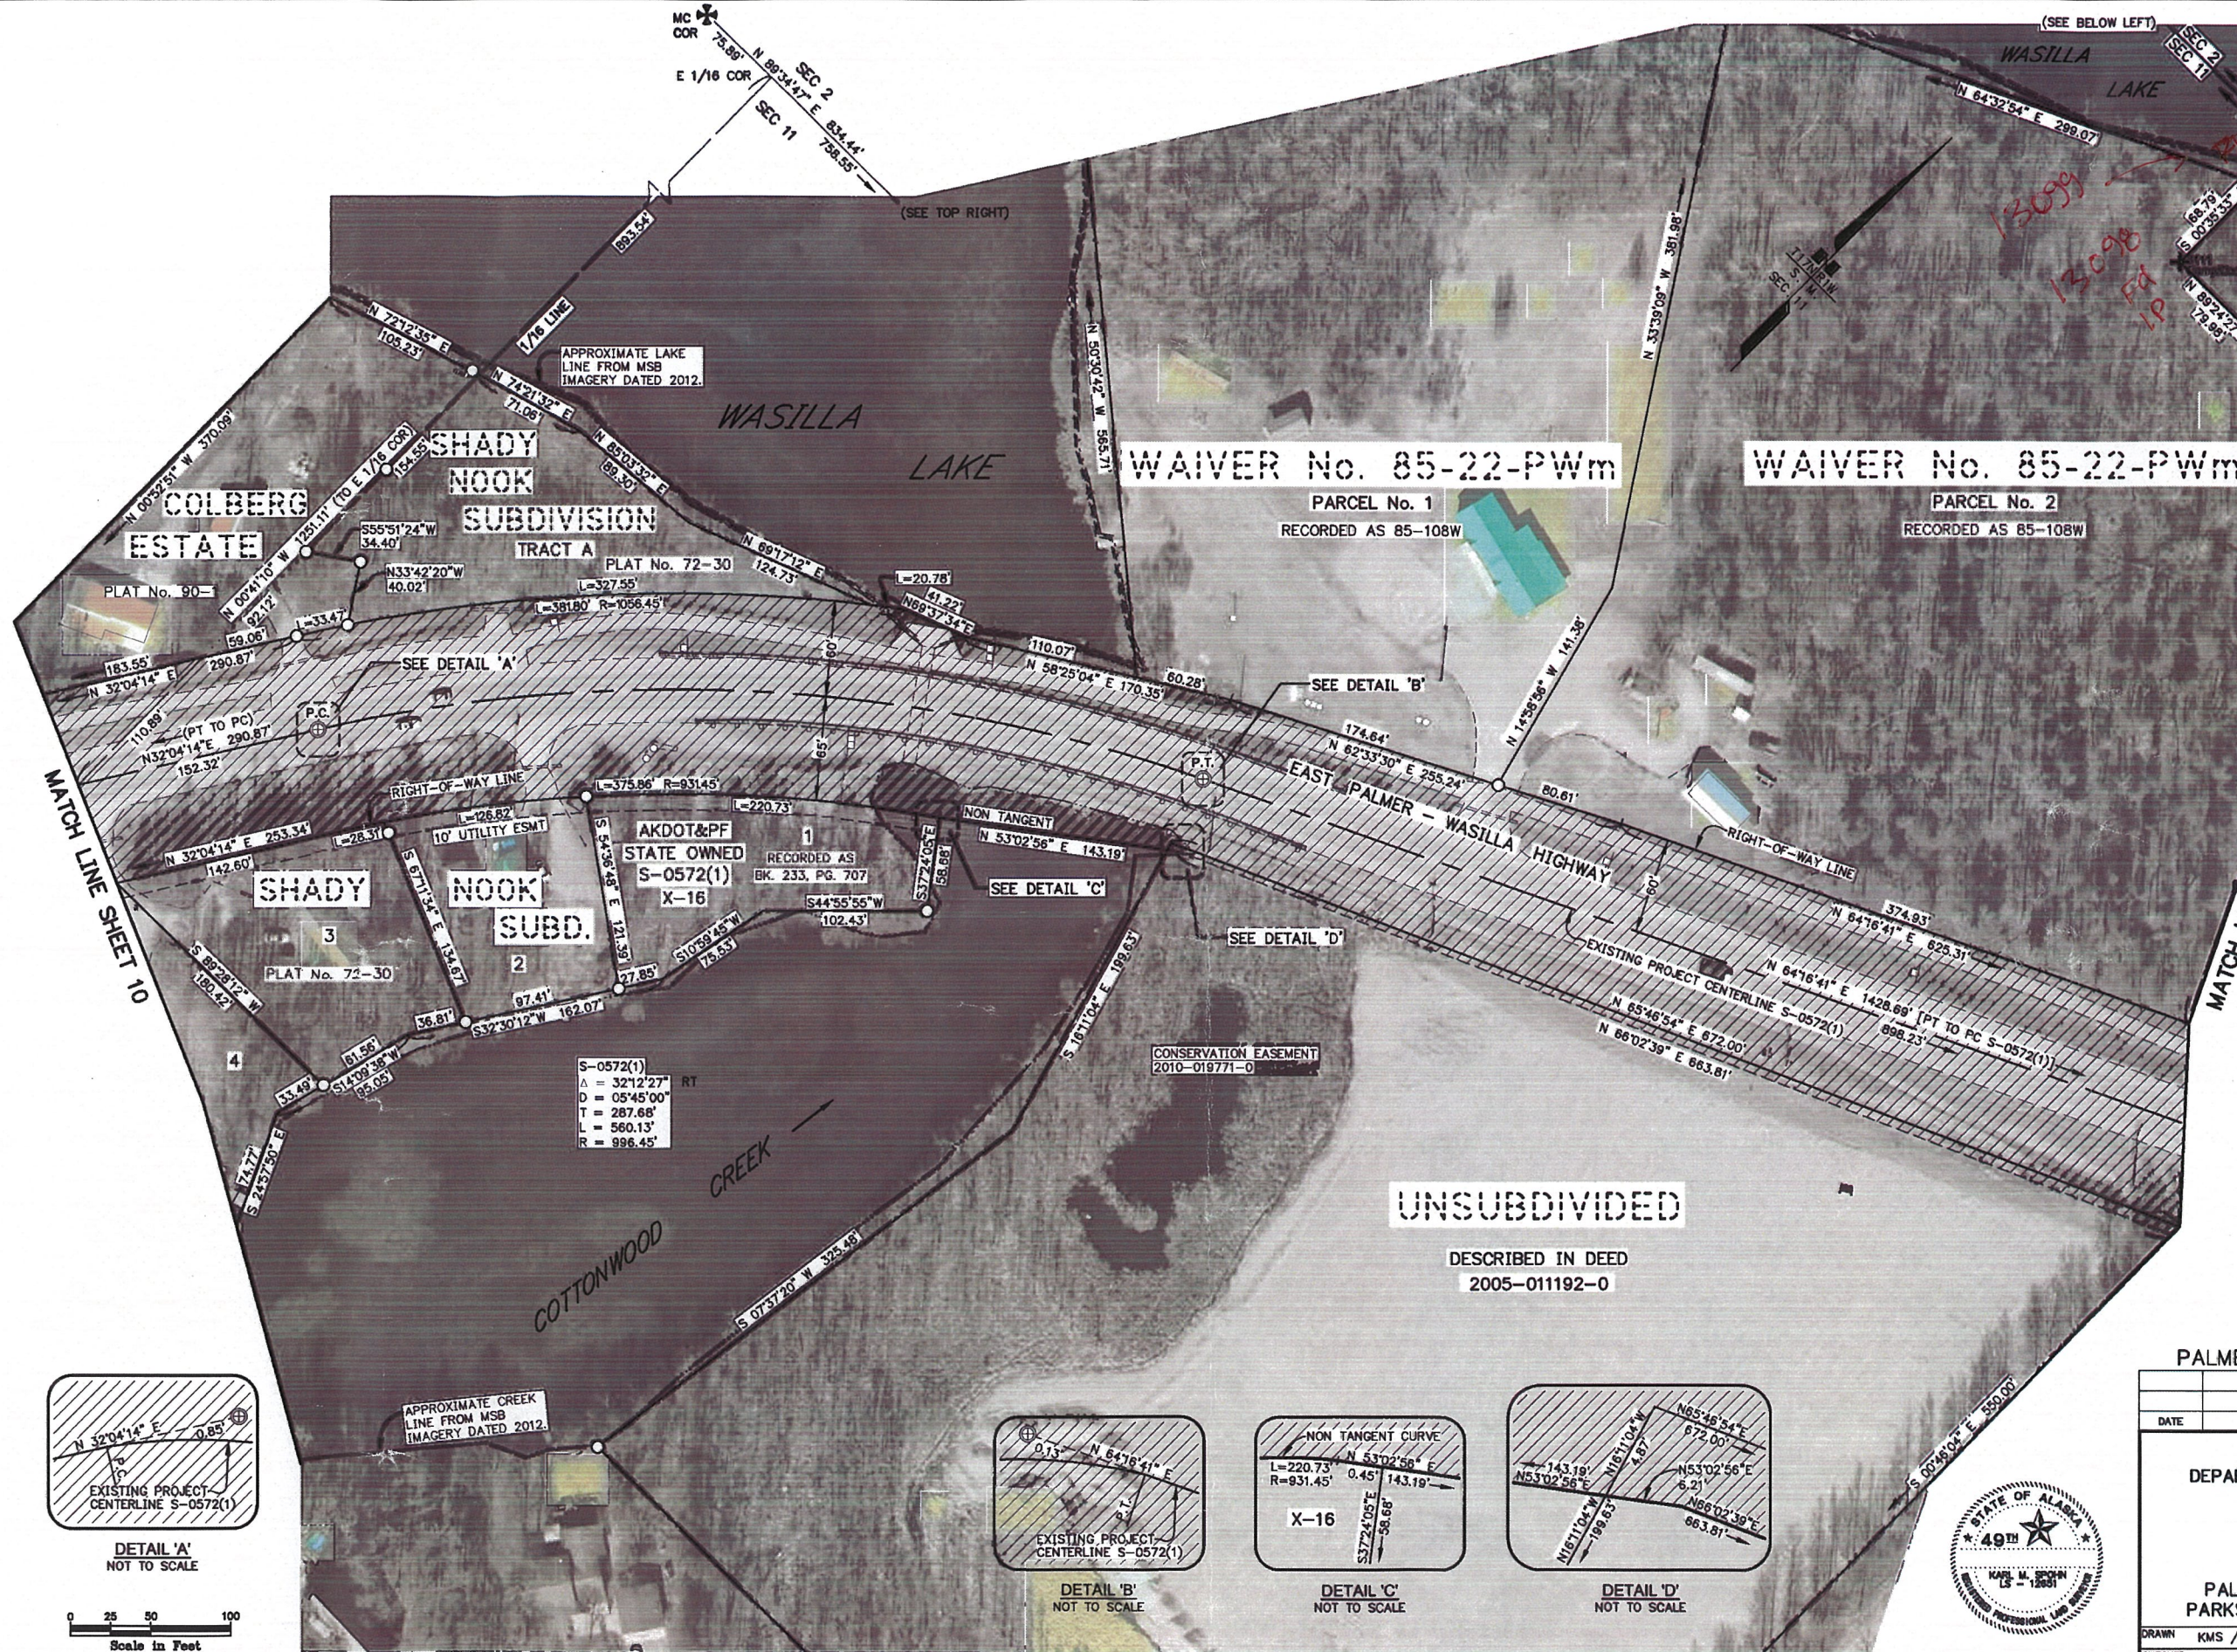

DETAIL 'B'
NOT TO SCALE

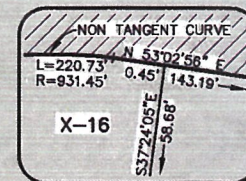

DETAIL 'C'
NOT TO SCALE

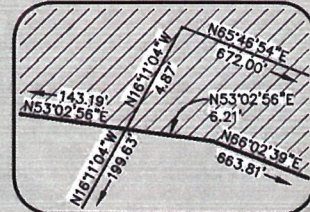

DETAIL 'D'
NOT TO SCALE



PALMER RECORDING DISTRICT		
DATE	REVISIONS	BY
STATE OF ALASKA DEPARTMENT OF TRANSPORTATION & PUBLIC FACILITIES RIGHT-OF-WAY BASE MAP ALASKA PROJECT 59271 PALMER - WASILLA HIGHWAY PARKS HIGHWAY TO TRUNK ROAD		
DRAWN KMS / GBE	DATE 7/22/2014	SCALE 1"=50'
CHECKED JRC / KMS	DATE 6/17/2014	SHEET 11 OF 41