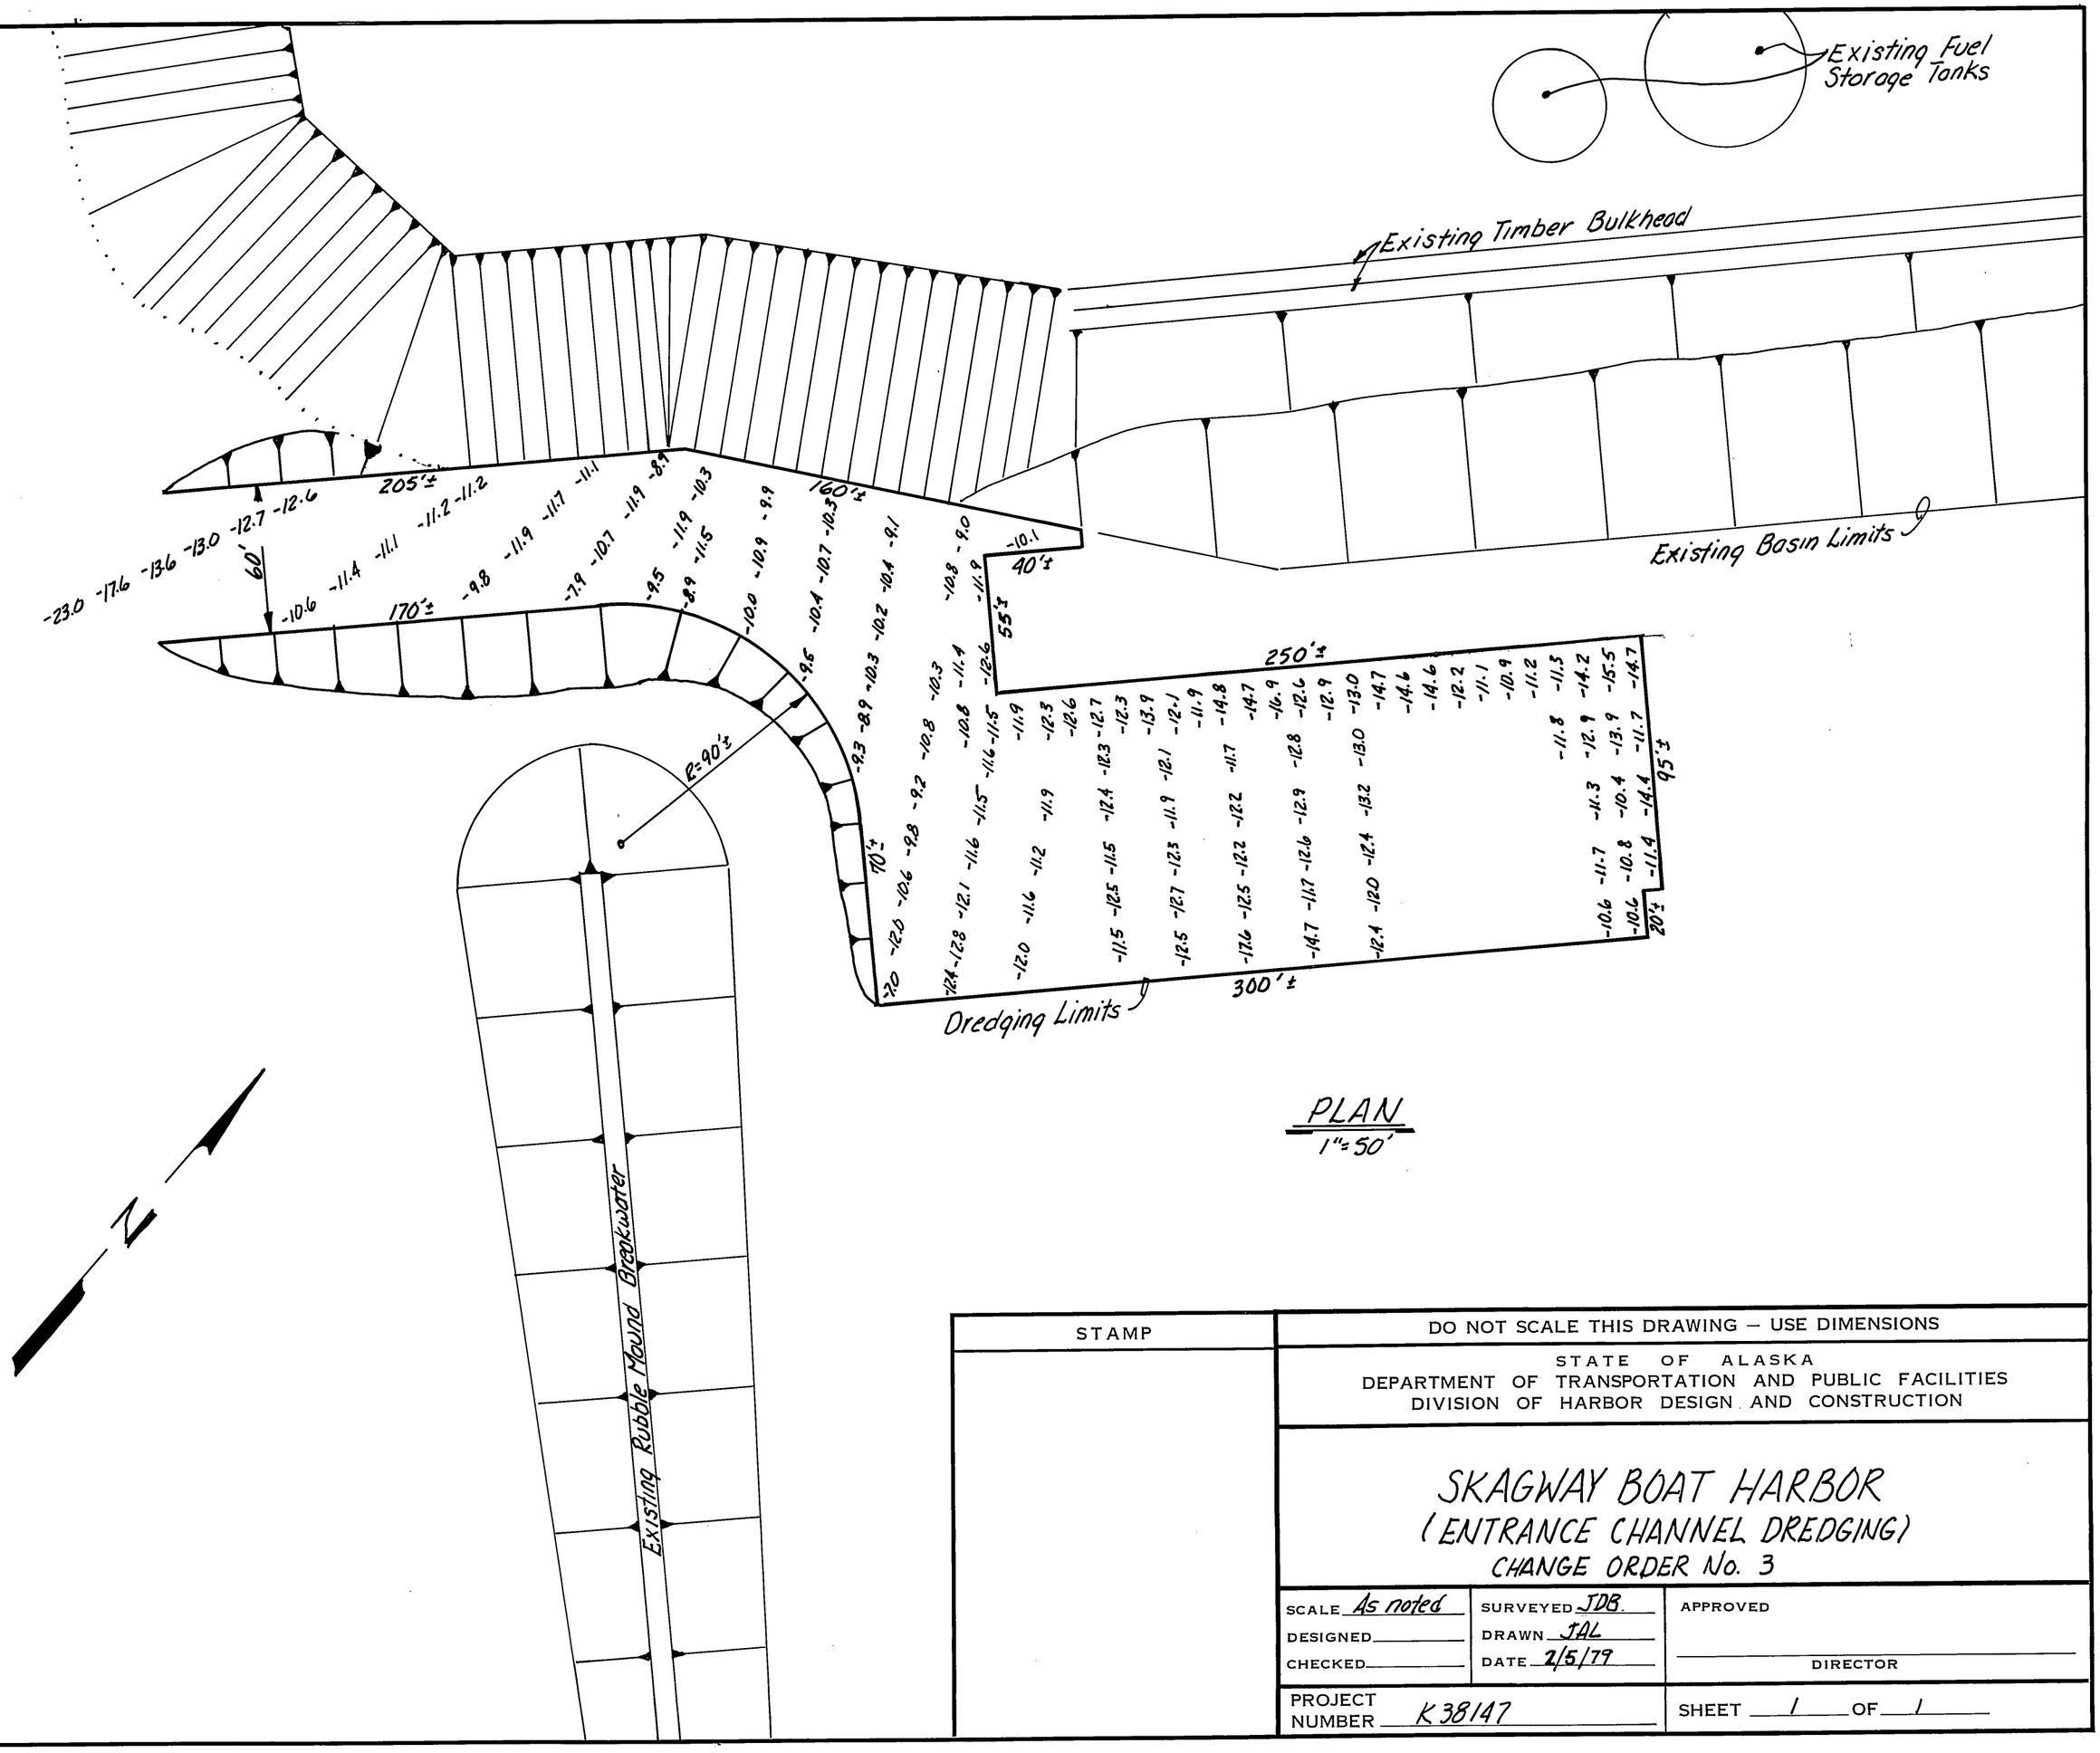

PLAN
1"=50'

STAMP	DO NOT SCALE THIS DRAWING — USE DIMENSIONS
	STATE OF ALASKA DEPARTMENT OF TRANSPORTATION AND PUBLIC FACILITIES DIVISION OF HARBOR DESIGN AND CONSTRUCTION
	SKAGWAY BOAT HARBOR (ENTRANCE CHANNEL DREDGING) CHANGE ORDER No. 3
	SCALE As noted · SURVEYED JDB · APPROVED DESIGNED · DRAWN JAL CHECKED · DATE 2/5/79 · DIRECTOR
	PROJECT NUMBER K 38147 · SHEET 1 OF 1